




MD 5 IS ASSUMED TO RUN
IN A NORTH-SOUTH DIRECTION

LED SIGNAL HEADS

EXISTING SIGNS

1-4
Y

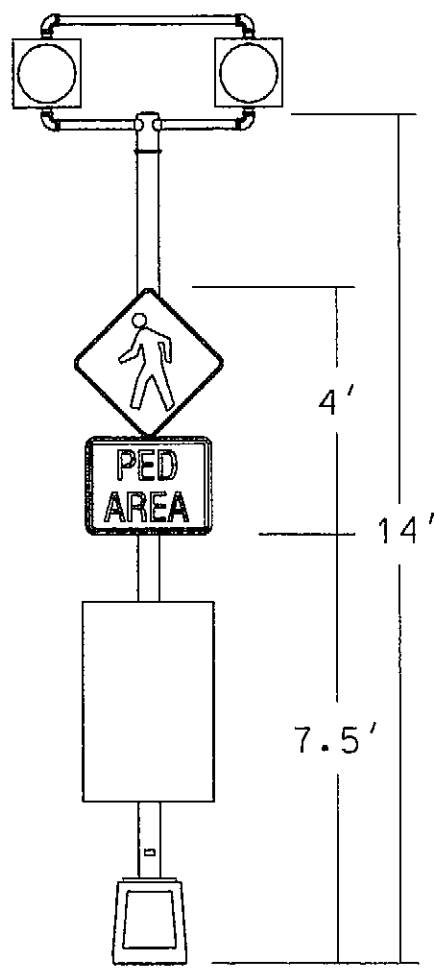

SCHOOL WARNING HIB
INSTALLATION DETAIL
NOT TO SCALE

MD 5 (POINTLOOK OUT ROAD)

ST. MARYS RIVER

AERIAL CABLE DETAIL	
PRIMARY	40' +
SECONDARY	35' +
GRADE	

AERIAL CABLE DETAIL	
COMMUNICATION	19' 0"
TELEPHONE	18' 0"
GRADE	

ST. MARYS COLLEGE

MILL FIELD
DRIVE

MD 5 (POINTLOOK OUT ROAD)

TO MD 235

GENERAL NOTES

1. THIS PLAN REFLECTS ONLY THOSE UNDERGROUND UTILITIES THAT WERE APPARENT AT THE TIME OF THIS ASBUILT. A DETAILED REVIEW WAS NOT UNDERTAKEN AND THE PLAN SHOULD NOT BE CONSTRUED AS REPRESENTING ALL UNDERGROUND UTILITIES IN THE AREA.
2. ANY MODIFICATION TO THIS SUBJECT SIGNAL SHOULD BE PRECEDED BY A THOROUGH IDENTIFICATION OF ALL EXISTING UTILITIES.

GEOMETRIC LEGEND

- EXISTING
- EDGE OF ROAD
- GUARDRAIL

UTILITY LEGEND

- SD STORM DRAIN
- G GAS MAIN
- W WATER MAIN
- S SEWER MAIN
- E ELECTRIC CABLES
- A AERIAL CABLES
- T TELEPHONE CABLES
- F FIBER-OPTIC

CONSTRUCTION NOTES

- A. 14 FT. BREAKAWAY PEDESTAL POLE WITH TYPE "G" POLE MOUNTED FLASHER CABINET WITH ALL NECESSARY EQUIPMENT, 12" YELLOW LED SIGNAL HEADS AND SIGNS (NOTE: 1-3 IN. PVC CONDUIT BENDS).
- B. HANDHOLE.
- C. EMBEDDED METERED SERVICE PEDESTAL.
- D. 2 IN. SCHEDULE 80 RIGID PVC CONDUIT-TRENCHED.
- E. 3 IN. SCHEDULE 80 RIGID PVC CONDUIT-TRENCHED.
- F. 4 IN. SCHEDULE 80 RIGID PVC CONDUIT-TRENCHED.
- G. UNDERGROUND ELECTRICAL SERVICE MAINTAINED BY SOUTHERN MARYLAND ELECTRIC CO-OP.
- H. OVERHEAD PHONE DROP MAINTAINED BY VERIZON.



SABRA, WANG & ASSOCIATES, INC.
1504 JOH AVENUE
SUITE 180
BALTIMORE, MD 21227
(410) 737-8564
WWW.SABRA-WANG.COM

APPROVALS
TEAM LEADER
ASST. DIV.
DIVISION CHIEF
OFFICE DIRECTOR

REVISIONS
ASBUILT 06/ /09
SHA CONTRACT NO. AT9365185 1051
SWA
C SHA CONTRACT NO. 04/ /07
MODIFY EXISTING H.I.B. POWER FEED TO METER SERVICE PEDESTAL
SWA

SHA STATE OF MARYLAND DEPARTMENT OF TRANSPORTATION STATE HIGHWAY ADMINISTRATION OFFICE OF TRAFFIC & SAFETY TRAFFIC ENGINEERING DESIGN DIVISION	
MD 5 NORTH OF ST. MARY'S COLLEGE ST. MARY'S CITY, MARYLAND	
TRAFFIC SIGNAL PLAN	
SCALE 1" = 20'	DATE JUNE / /2009 CONTRACT NO. AT9365185
DESIGNED BY	COUNTY ST. MARY'S
DRAWN BY J. WOOD	LOGMILE 18000511.17
CHECKED BY	T.I.M.S. NO. 1051
F.A.P. NO.	TOD NO. N/A
DRAWING NO. 4766	SHEET NO. 1 OF 2